




LOCATION MAP
STATE OF OREGON
NOT TO SCALE



VICINITY MAP
NOT TO SCALE

PROJECT LOCATION

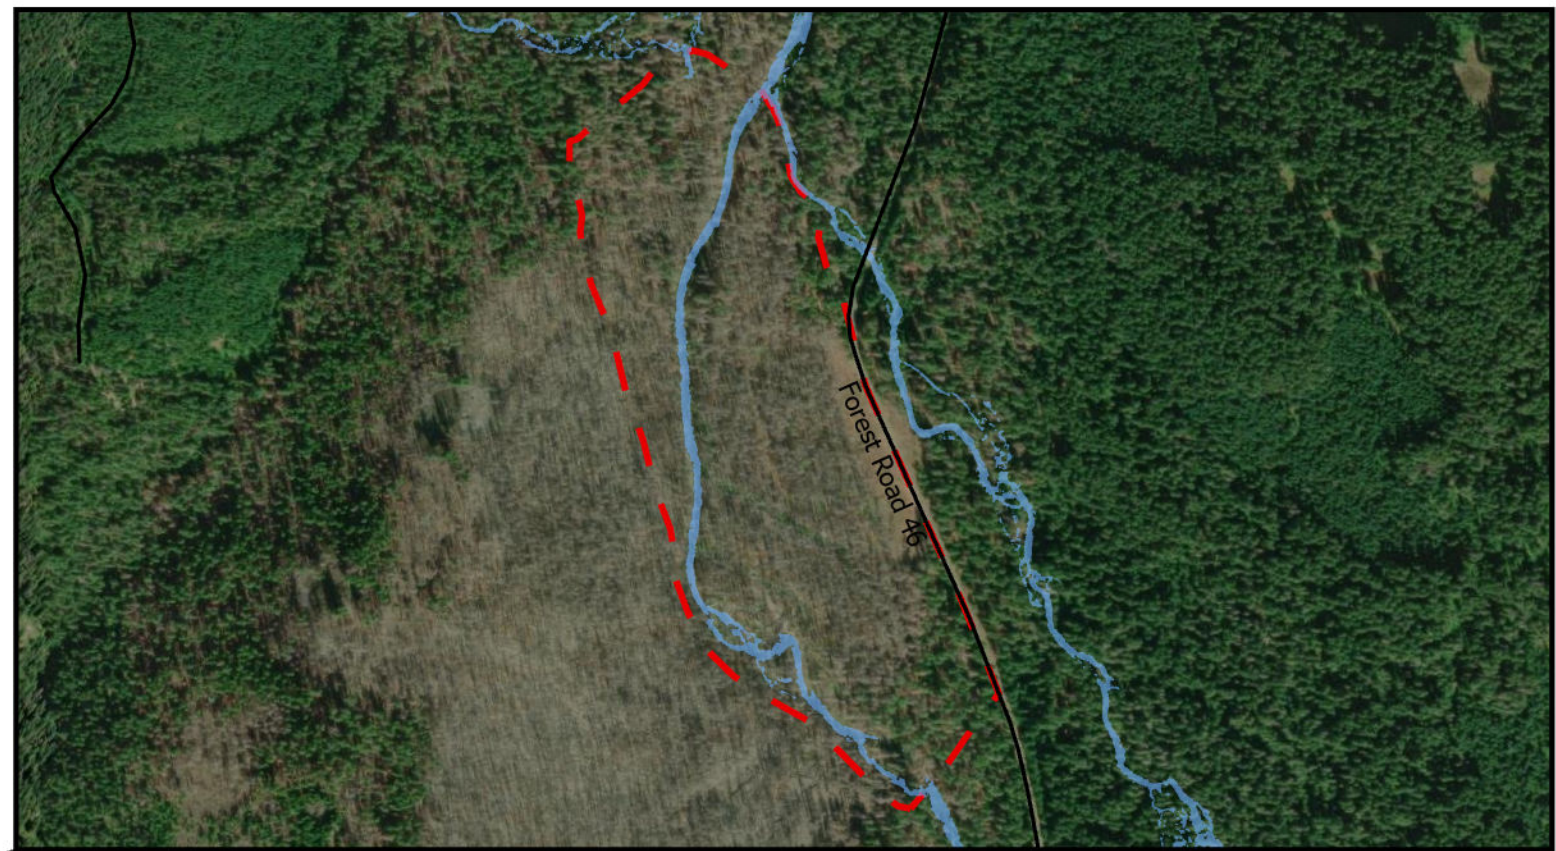

SITE MAP
NOT TO SCALE

SHEET INDEX

1. COVER, LOCATION, AND INDEX SHEET
2. PLAN VIEW OF PHASE 1, COMPLETED
3. PLAN VIEW OF PROPOSED PHASE 2 CONDITIONS
4. VALLEY RESET TYPICAL DRAWINGS
5. ISLAND JAM TYPICAL DRAWINGS
6. PLAN VIEW OF PLANTING ZONES
7. PLANTING LIST

COORDINATES:

LATITUDE: 44 DEG 54'11"N
LONGITUDE: 121 DEG 53'36"W

SECTION 1 AND 12, TOWNSHIP 8S, RANGE 7E

WATERBODY: CUB CREEK
TRIBUTARY TO CLACKAMAS RIVER

DH
DRAWN

DH
DESIGNED

KM
CHECKED

10/25/23
DATE


CUB CREEK CONFLUENCE
PHASE 2
PRELIMINARY DESIGN



COVER, LOCATION, AND INDEX
SHEET

SHEET

1 OF 7

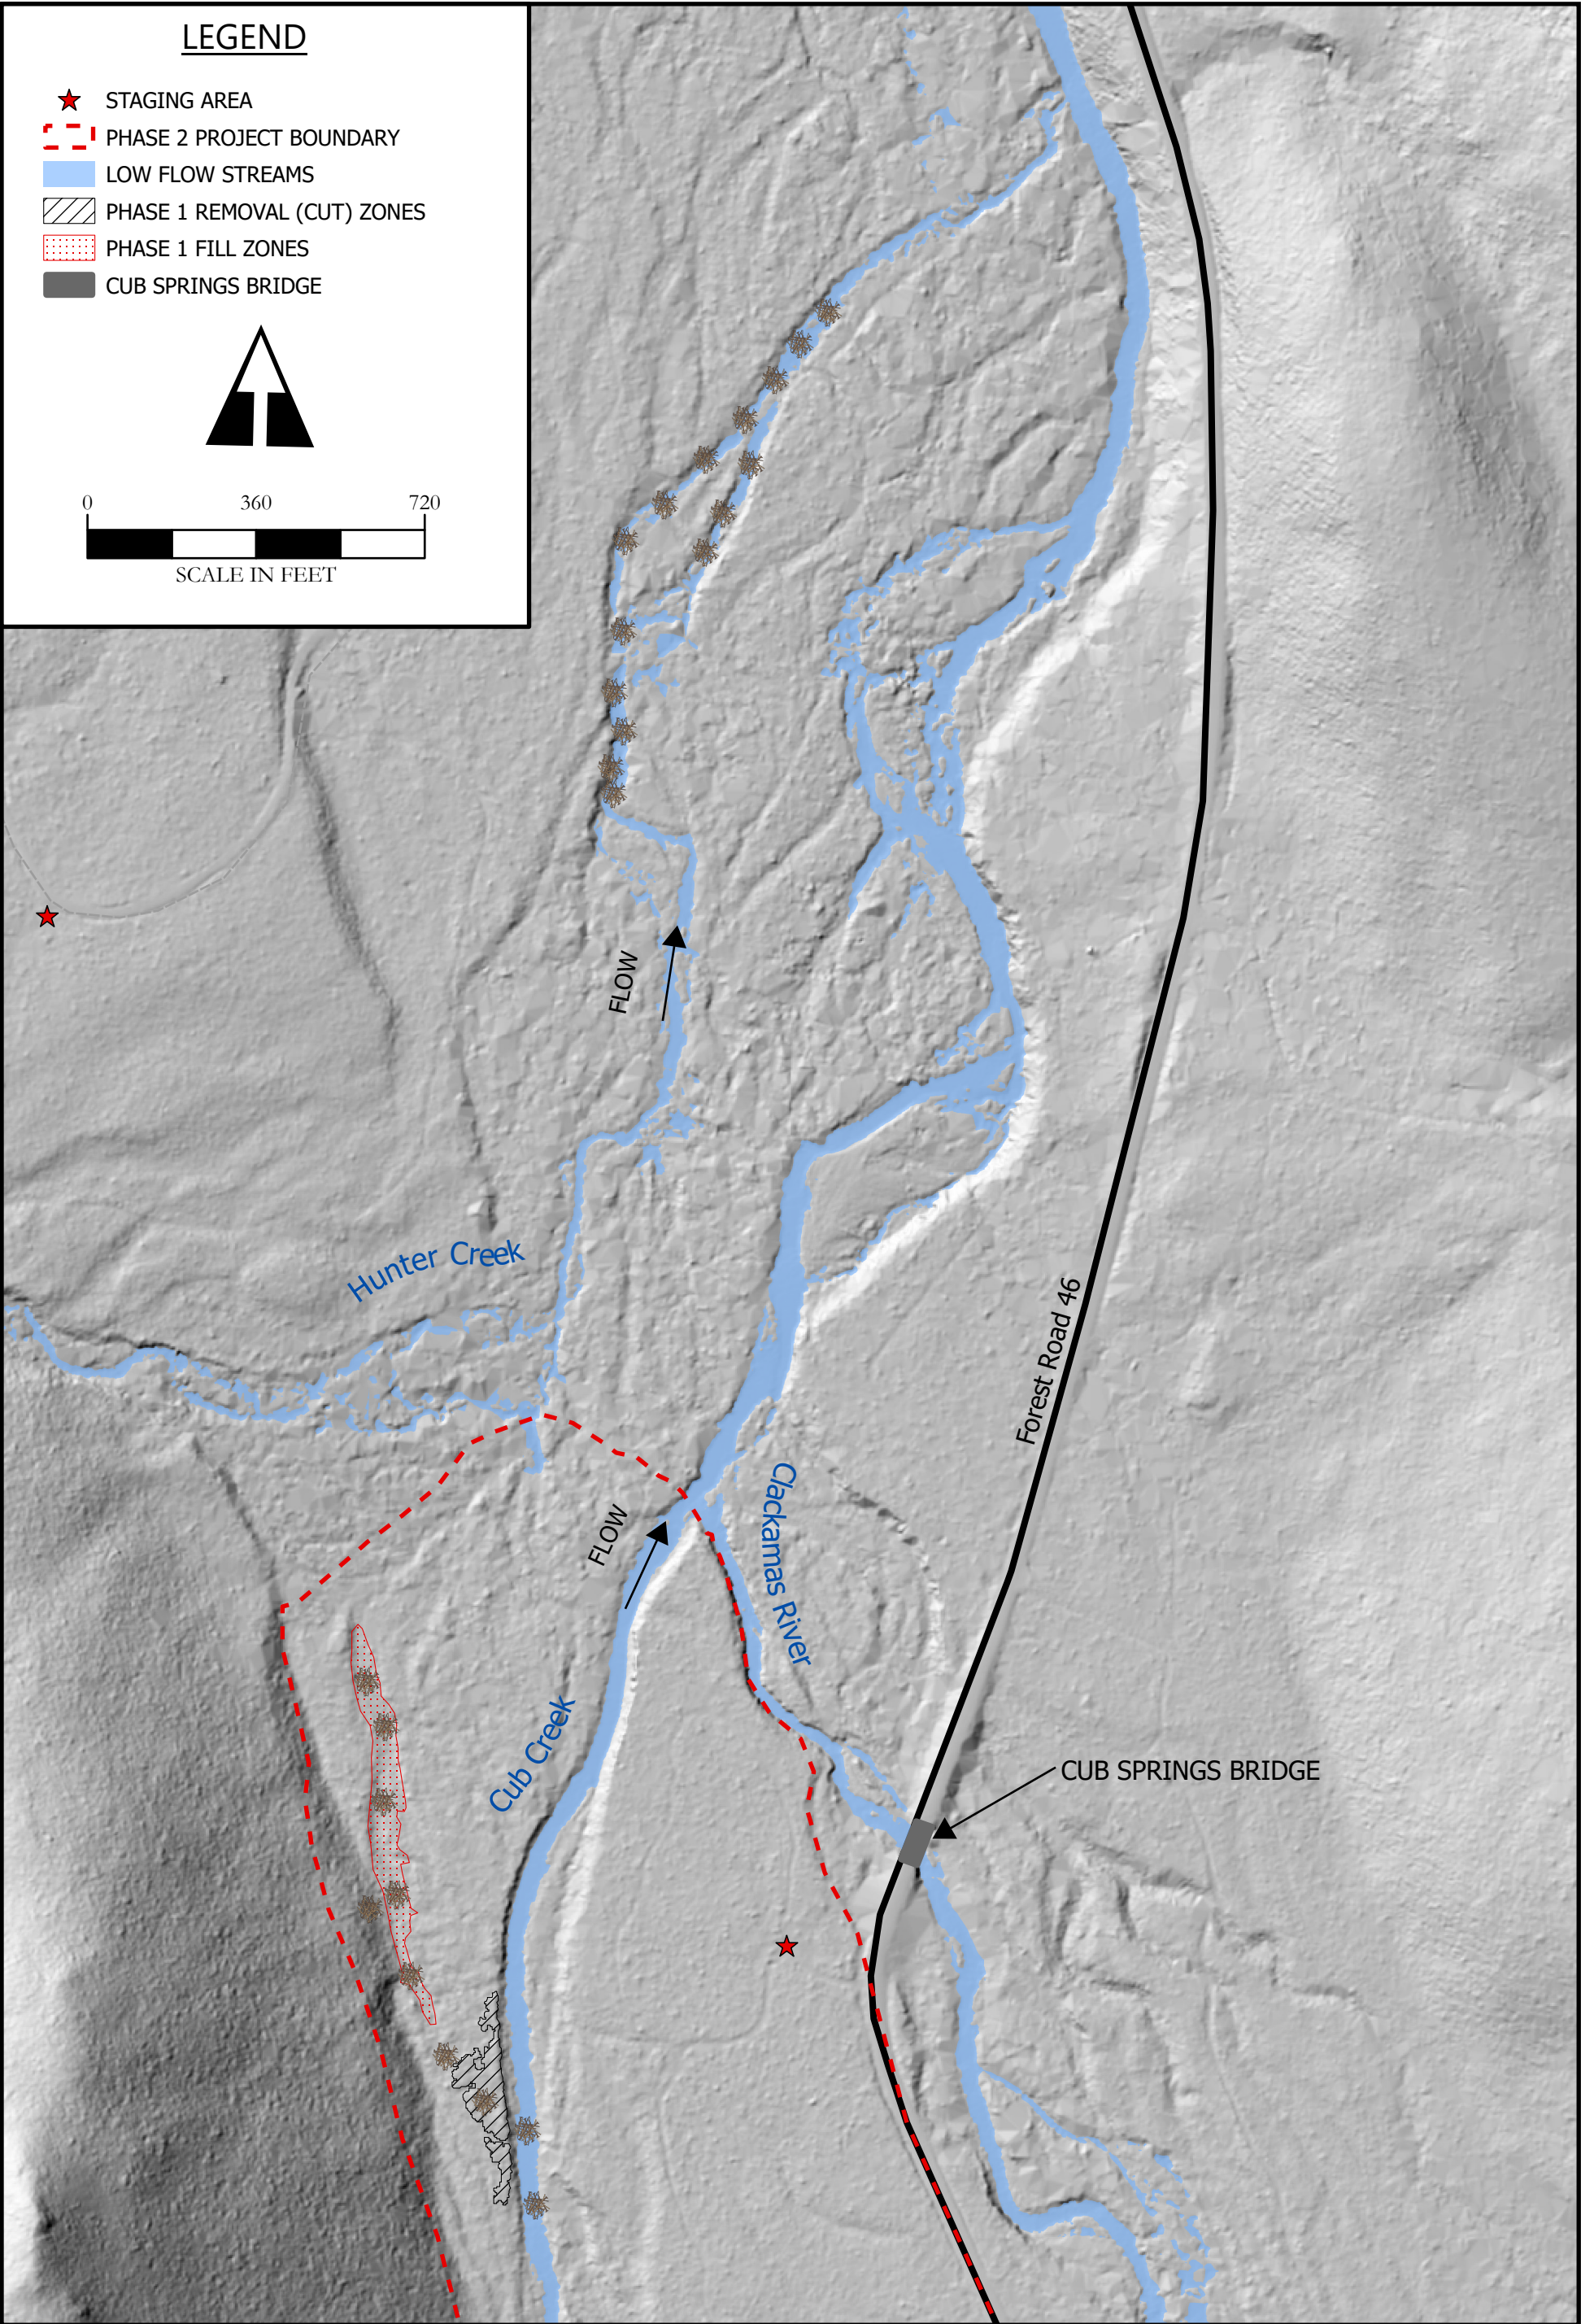

DH DRAWN/DESIGN MH CHECKED 10/25/23 DATE		CUB CREEK CONFLUENCE PHASE 1 AS-BUILT/COMPLETED				PLAN VIEW OF PHASE 1 AS-BUILT		SHEET 2 OF 7	
---	--	--	--	---	--	--	--	------------------------------------	--